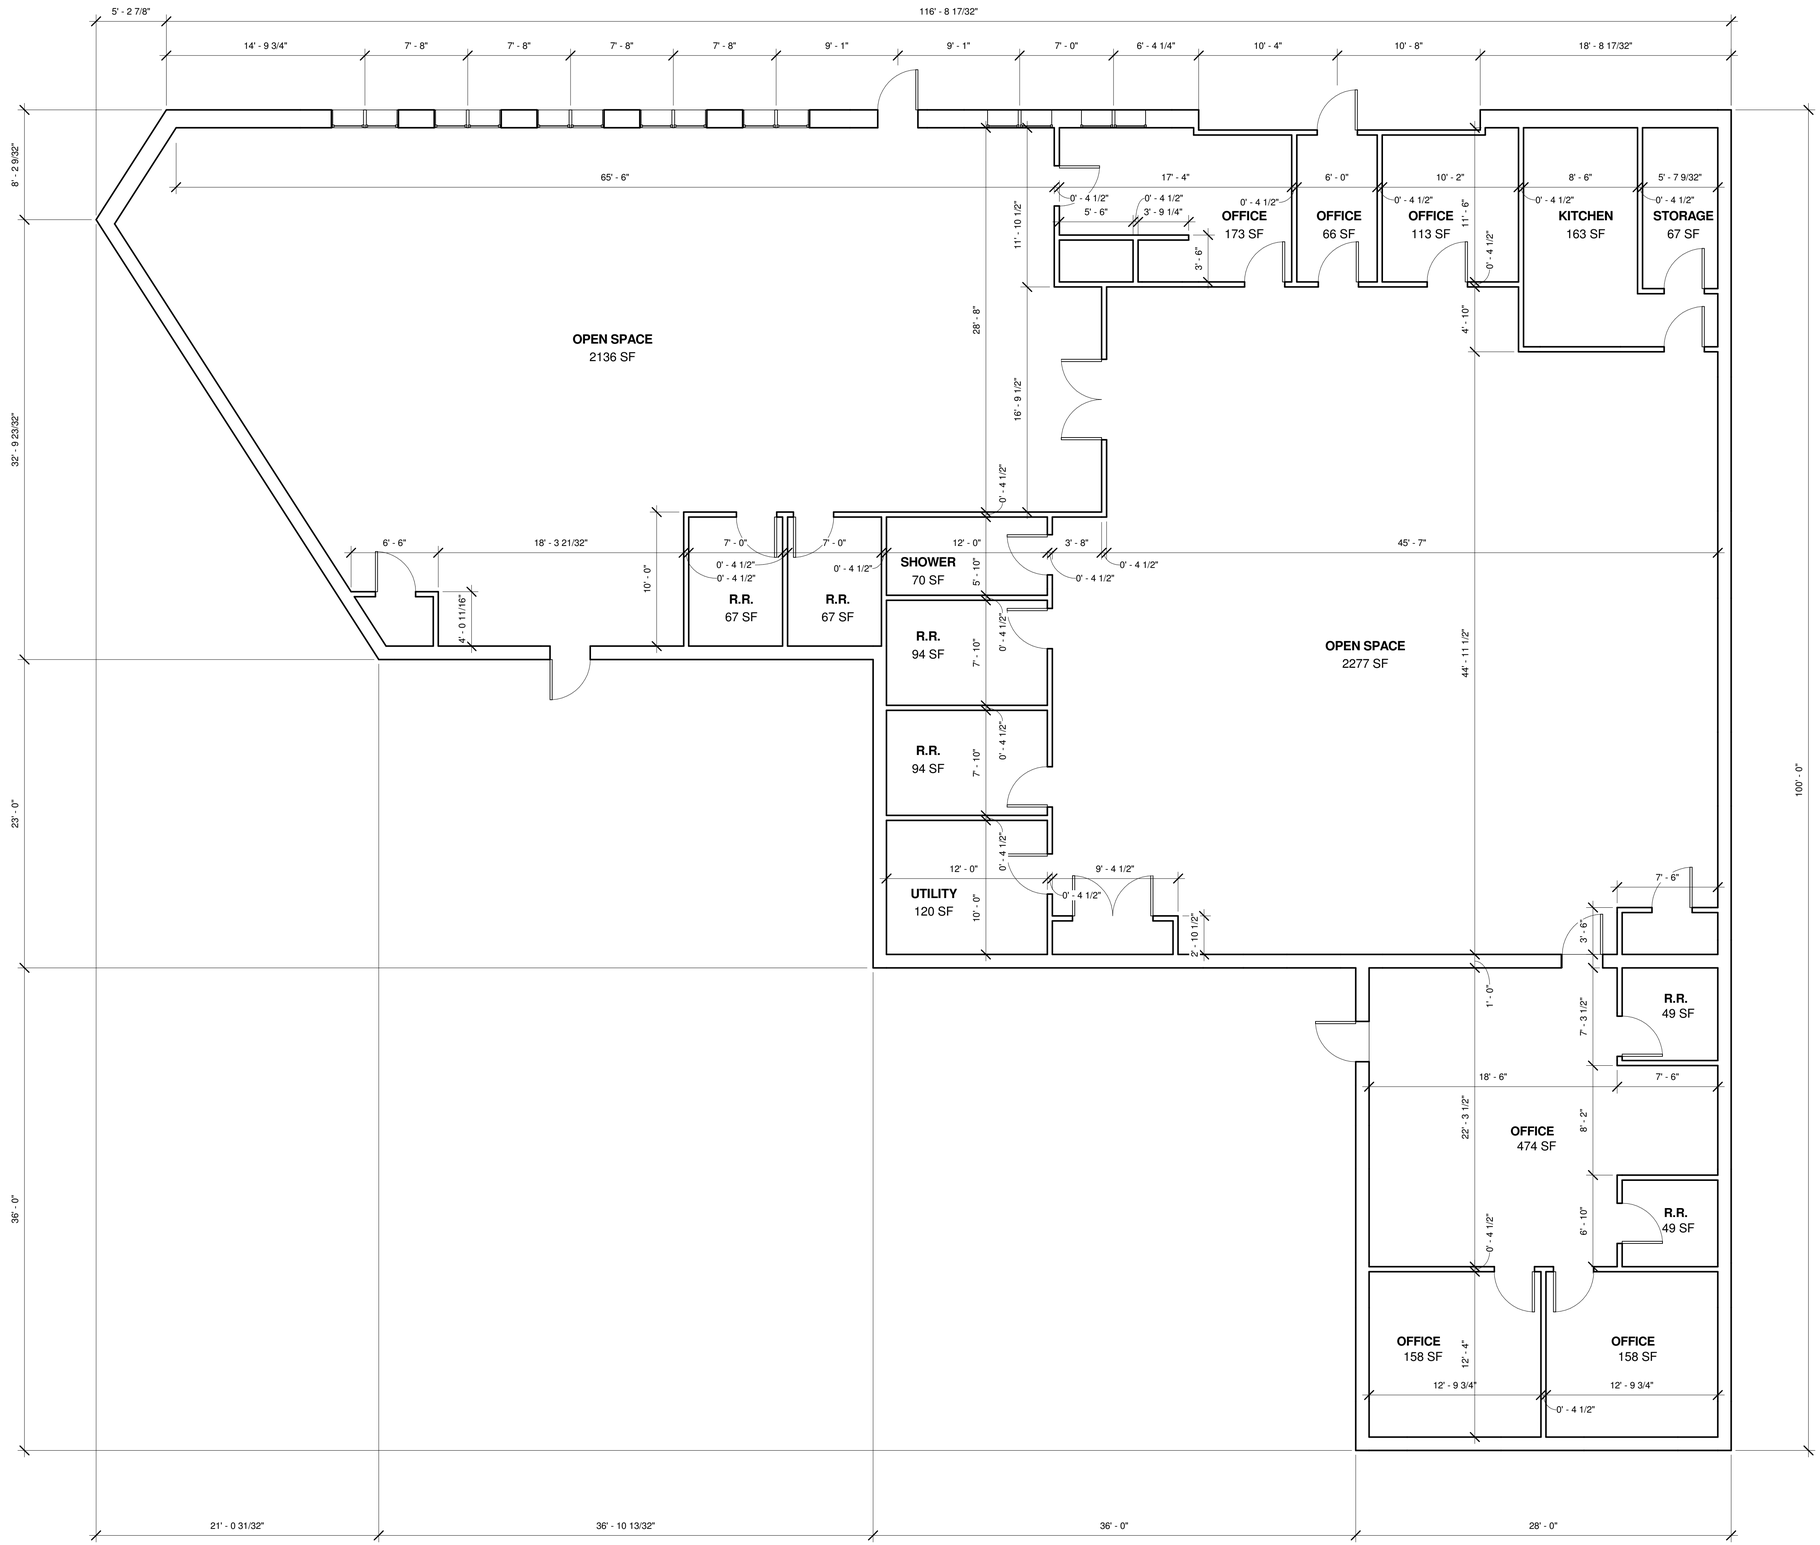

1 EXISTING FLOOR PLAN
3/16" = 1'-0"

VIRTUOSO DESIGN PLUS BUILD
www.virtuosodesignbuild.com
313-965-5056
info@virtuosodesignbuild.com

ANDREW RAUPP

AS-BUILTS

865 Holden Street
Detroit, MI

Unauthorized use of this drawing set without written permission from VIRTUOSO DESIGN + BUILD is in violation of U.S. COPYRIGHT LAWS and will be subject to civil damages and prosecution.

No.	Description	Date

FLOOR PLAN

A101

Drawn by	Author
designed by	Checker

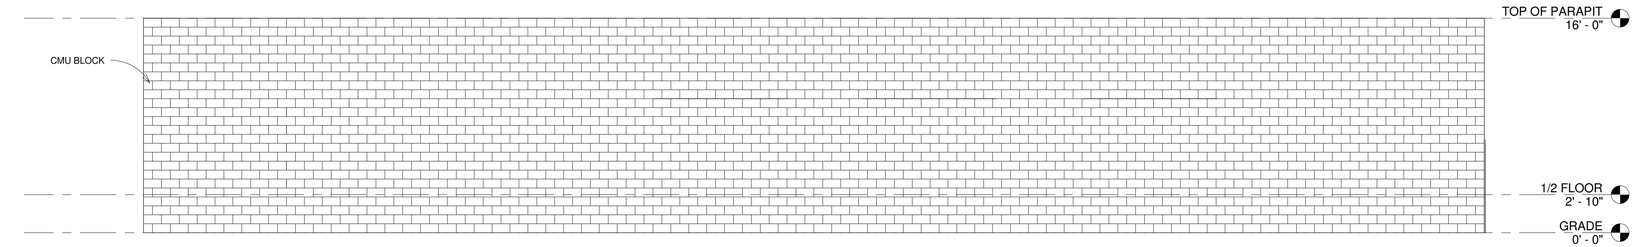

1 EAST ELEVATION
3/16" = 1'-0"

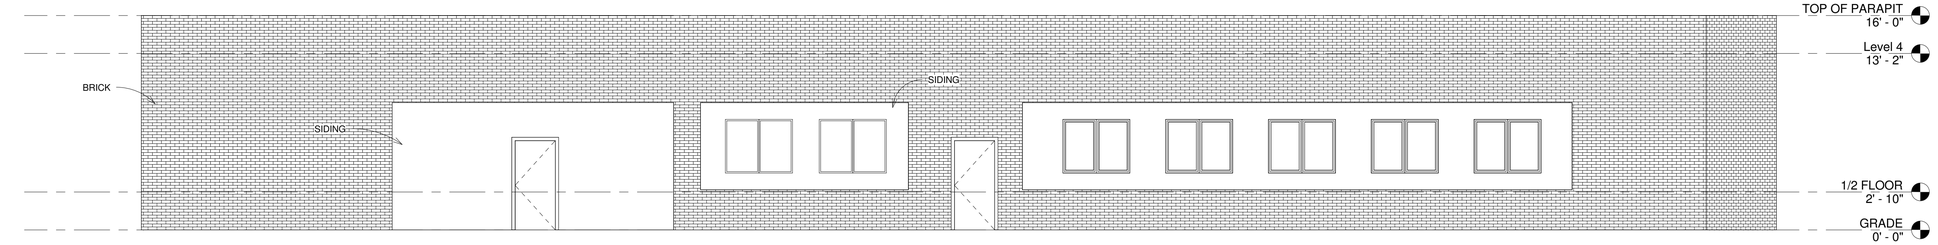

2 NORTH ELEVATION
3/16" = 1'-0"

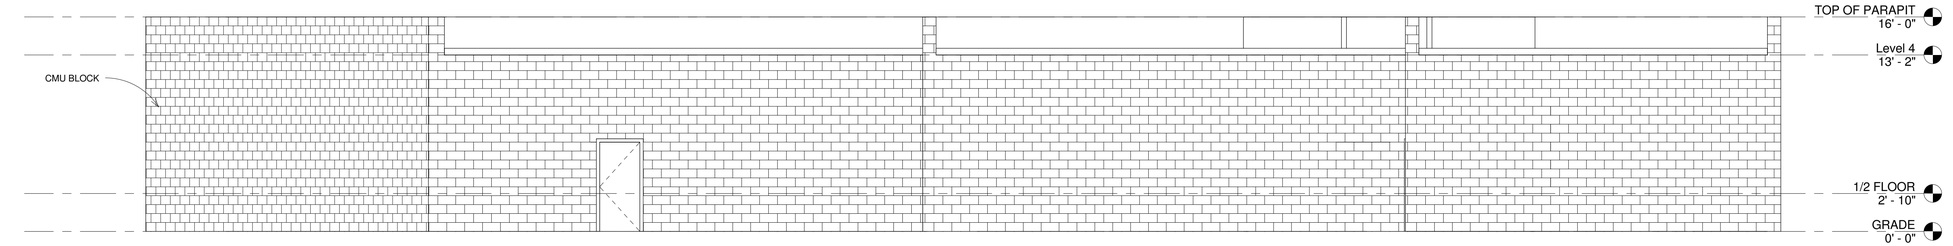

3 SOUTH ELEVATION
3/16" = 1'-0"

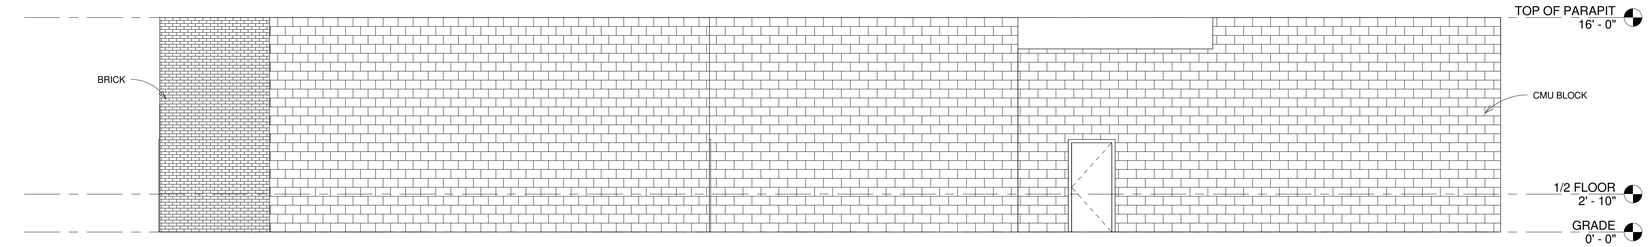

4 WEST ELEVATION
3/16" = 1'-0"

VIRTUOSO DESIGN PLUS BUILD
www.virtuosodesignbuild.com
313-965-5056
info@virtuosodesignbuild.com

ANDREW RAUPP

AS-BUILTS

865 Holden Street
Detroit, MI

Unauthorized use of this drawing set without written permission from VIRTUOSO DESIGN + BUILD is in violation of U.S. COPYRIGHT LAWS and will be subject to civil damages and prosecution.

No.	Description	Date

ELEVATIONS

A102

Drawn by	Author
designed by	Checker